


NOTES

1. ALL CALCULATIONS INDICATE "GROSS RETAIL" AREA AS PER "BOMA" STANDARDS.
2. ALL FIXTURES INDICATED ARE BUILT-IN.
3. ALL FLOORS ARE CARPET UNLESS OTHERWISE INDICATED.
4. ALL CEILING HEIGHTS ARE 8'-0" UNLESS OTHERWISE NOTED.
5. ALL DIMENSIONS TO BE FIELD VERIFIED PRIOR TO ANY CONSTRUCTION.

AREA CALCULATIONS:

AREA 1539.50 SQ. FT.

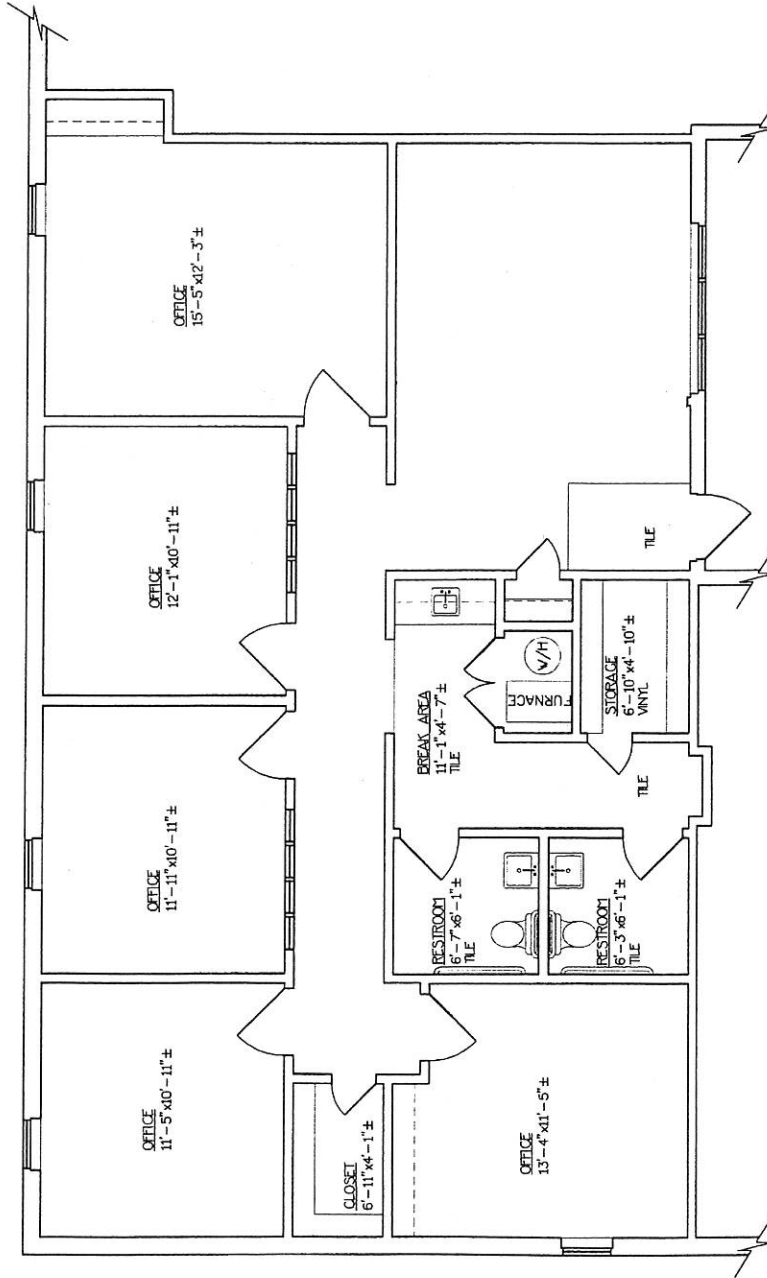

PROJECT 1110 PENNSYLVANIA ST N.E. SUITE B	DESCRIPTION AS-BUILT DRAWING	CUSTOMER PAT MCMULLEN
---	------------------------------------	-----------------------------

SHEET #	01
OF	01
MEASURED BY	P.M.
DESIGNED BY	N.A.
DRAFTED BY	P.M.
CHECKED BY	M.G.
REVISION	N 3
DATE	10/25/11
SCALE	3/16" = 1'-0"
	8

